
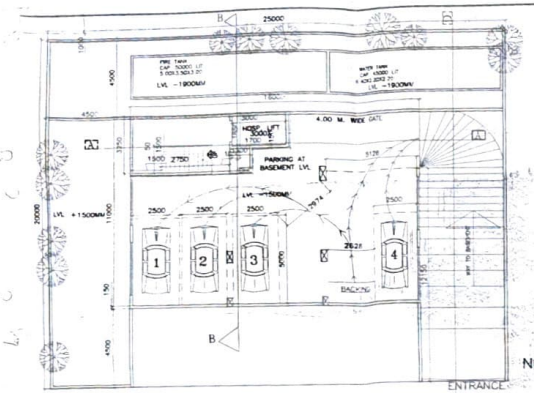


15M. WIDE ROAD

BASEMENT FLOOR PLAN

SCALE 1 : 100

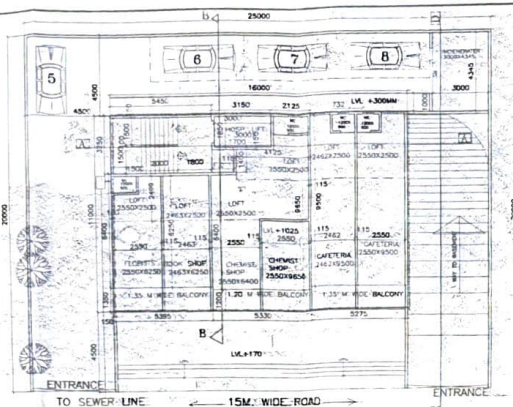


TO SEWER LINE

15M. WIDE ROAD


GROUND FLOOR PLAN

SCALE1:100

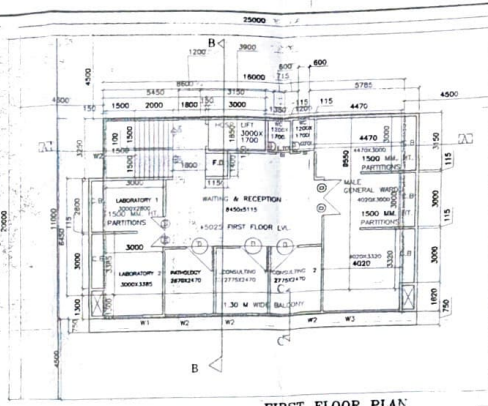


FIRST FLOOR PLAN

SCALE 1 : 100

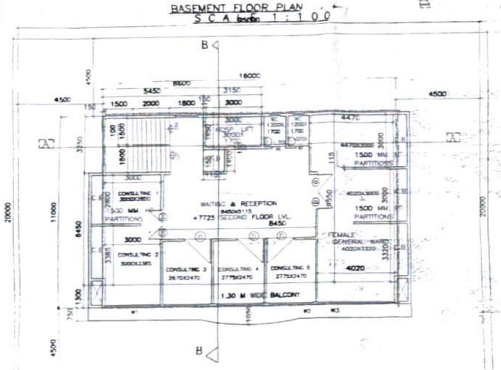


SECOND FLOOR PLAN

SCALE 1 : 100

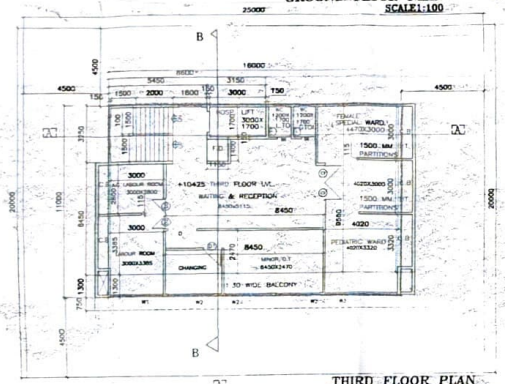


THIRD FLOOR PLAN

SCALE 1 : 100

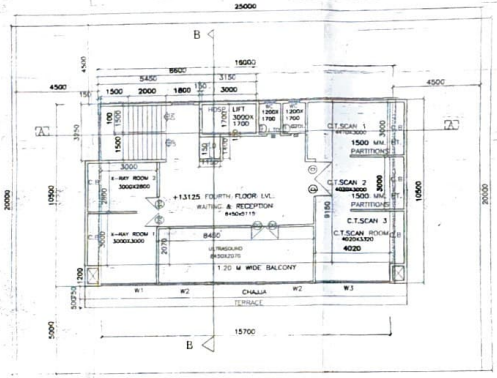


FOURTH FLOOR PLAN


SCALE 1 : 100

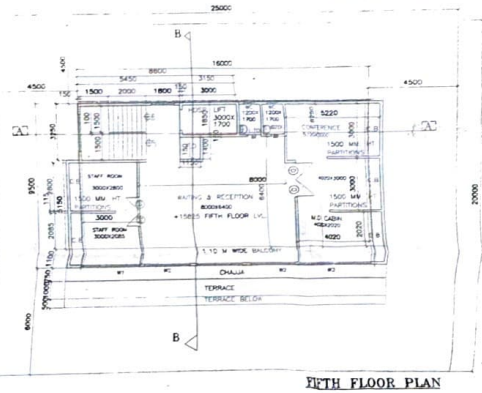

FIFTH FLOOR PLAN

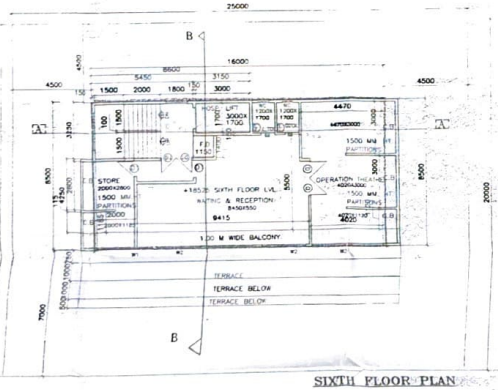

SIXTH FLOOR PLAN

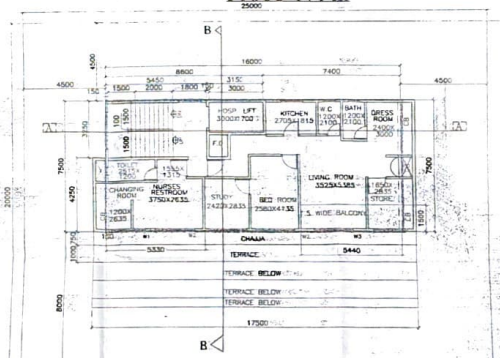

SEVENTH FLOOR PLAN

AS BUILT DRAWING

Approved subject to the conditions mention in this office letter No. CIDCO/BP-1221/ dtd. 1/10/13

Additional Town Planning Officer,
CIDCO of Maharashtra Ltd.,
4th Floor, Belapur Bhavan,
Sector 11, C.B.D. Belapur, Navi Mumbai.

TRUE COPY

A. D. SHROFF
Nursery Greater Bom
Shop No. "N" Dr. H
Opp. S. I. P. Ltd.
Chembur Colony, Mumbai

NOTE:
ARTIFICIAL LIGHT AND VENTILATION SHALL BE PROVIDED AS PER NBC PART 8 CLAUSES 4.1.2 AND 4.1.2.2 AND AN MODIFICATIONS THERE OF.

STAMP AND DATE OF APPROVAL

LIGHT & V.E VENTILATION STATEMENT

FLOOR			REQ.	PROV.	
BASEMENT					
	LIGHT	2.30X40.45	18.40	23.4	4.41
	VENT	2.30X40.45	18.40	23.4	4.41
	LIGHT	2.30X9.80	18.40	5.70	4.41
	VENT	2.30X9.80	18.40	5.70	4.41
	LIGHT	2.30X9.80	18.40	5.70	4.41
	VENT	2.30X9.80	18.40	5.70	4.41
STAIR					
	LIGHT	1.20X2.1	1.68	3.60	3.41
	VENT	1.20X2.1	1.68	3.60	3.41
TOILET					
	LIGHT	1.20X0.75	0.45	0.90	0.90
	VENT	1.20X0.75	0.45	0.90	0.90
	LIGHT	1.20X0.75	0.45	0.90	0.90
	VENT	1.20X0.75	0.45	0.90	0.90

SCHEDULE OF DOORS & WINDOWS

SR.NO	TYPE	DESCRIPTION	SIZE	AREA
W1	W	1.5 M. DECORATIVE	1.50X1.2	1.80
W2	W1	1.0 M. DECORATIVE	1.00X1.20	1.20
W3	W2	1.5 M. SLIDING G. WINDOW	1.50X1.20	1.80
W4	W3	1.2 M. SLIDING G. WINDOW	1.20X1.20	1.44
W5	W4	1.5 M. SLIDING G. WINDOW	1.50X1.20	1.80
W6	W5	1.2 M. SLIDING G. WINDOW	1.20X1.20	1.44
W7	W6	1.5 M. SLIDING G. WINDOW	1.20X1.2	1.44

WATER STORAGE CA.

		UNIT	MEM.	L/T	TOTAL
HEALTH USE'S	10 BED HOSP. ON EACH FLOOR	6	10	340LTR	20,400
COMM.	10 BED HOSP.	6	3	45LTR	810
RES.	UNIT OF BUA 60 SQ.M.	1	7	200LTR	1400
TOTAL					22,610
U.G.TANK REQUIREMENT 50% OF TOTAL QUANTITY				PROPOSED	11,305 30,000
O.H.T.TANK REQUIREMENT 75% OF TOTAL QUANTITY				PROPOSED	16,960 20,000

PARKING DETAILS

	REQ.NO.	UNIT	PROP.NO.
SHOP/PANTRY	1 NO. FOR EVERY 50 SQ.M.	86.54	1
HEALTH USE'S	1 NO. 150 SQ.M.	785.34	5
RES.	1 NO FOR EVERY UNIT OF B.U.A. UPTO LESS THAN 455 SQ.M.	1	1
VISITORS	10% OF TOTAL PARKING SPACES		1
	TOTAL		8

NAME AND SIGN OF OWNER

Vijaykumar Dayashnah Agarwal
Bhagwandas Vijaykumar Agarwal

NAME AND SIGN OF ARCHITECT

PROP. HOSPITAL ON PLOT NO 5A
SEC.4, KHARGHAR, NAVI MUMBAI

FLOOR PLANS, ELEVATION & SECTION

JOB NO.KK/SNM/2004-22 SCALE 1:100

DATE 25/01/06 DRN.JOB.PC

01

SHIPRA'S SHILP
ARCHITECT/PLANNER/INTERIOR DESIGNER

LIGHT & 1/6 VENTILATION STATEMENT

S.N.	F. NO	ROOM	SIZE	AREA	1/6th L/V	V. PROV.	
(1)	GR.FL	FLORIST	2.55X6.45	16.44	2.74	4.41	
		BOOKSHOP	2.46X6.45	15.88	2.64	4.41	
		CHEMIST	2.55X6.60	16.83	2.80	4.41	
		CHEMIST	2.55X9.85	24.81	4.10	6.21	
		CAFETERIA	2.46X9.6	23.61	3.94	6.21	
		CAFETERIA	2.55 X9.6	24.48	4.01	6.21	
(2)	1st.FL	HOSPITAL	2.55 X9.6	24.48	4.01	6.21	
			1.3X2.3	2.99	0.498	0.54	
		TOI	1.8X2.5	4.14	0.69	0.72	
		TOI	1.8X2.5	4.14	0.69	0.72	
		BED	4.175X2.703	11.126	1.854	2.88	
		BED	3.155X3.755	11.843	1.974	2.88	
		TOI	1.3X2.3	2.99	0.498	0.54	
		TOI	1.3X2.3	0.77	0.14	W1	
(3)	2nd.FL						

SCHEDULE OF DOORS & WINDOWS

S.N.	TYPE	DESCRIPTION	SIZE	AREA
(1)	D	T.W. DECORATIVE	1.5X2.1	3.15
(2)	D1	T.W. DECORATIVE	1.0X2.10	2.10
(3)	D2	SINTEX DOORS	0.75X2.10	1.575
(4)	W1	AL.SLIDING G.WINDOW	3.00X1.80	5.40
(5)	W2	AL.SLIDING G.WINDOW	2.4X1.8	4.32
(6)	W3	AL.SLIDING G.WINDOW	4.0X1.8	7.20
(7)	W4	AL.SLIDING G.WINDOW	1.2X1.2	1.44

WATER STORAGE CAL.

		UNIT	MEM.	/LT	TOTAL
HEALTH USER	10 BED HOSP. ON EACH FLOOR	6	10	340LTR	20,400
COMM.	10 BED HOSP.	6	3	45LTR	810
RES.	UNIT OF BUA 60 SQ.M.	1	7	200LTR	1400
TOTAL					22,610
U G TANK REQUIREMENT 50% OF TOTAL QUANTITY					11,305
PROPOSED					30,000
O.H TANK REQUIRENMENT 75% OF TOTAL QUANTITY					16,960
PROPOSED					20,000

PARKING DETAILS

	REQ.NO	UNIT	PROP.NO
SHOPPING	1 NO. FOR 80 SQ.M.	86.54	1
HEALTH USER	1 NO. 150 SQ.M.	785.34	5
RES.	1 NO FOR 2UNITS OF B.U.A MORE THAN 45SQ.M. UPTO 60 SQM	1	1
VISITORS	10% OF TOTAL PARKING SPACES		1
	TOTAL		8

NAME AND SIGN OF OWNER

Vijaykumar Omprakash Agarwal

Smt. Sarita Vijaykumar Agarwal

NAME AND SIGN OF ARCHITECT

PROP. HOSPITAL ON PLOT NO 5A
SEC.4, KHARGHAR, NAVI MUMBAI

FLOOR PLANS, ELEVATION & SECTION

NORTH

JOB NO.KK/NNM/2004-22 SCALE 1:100

01

DATE 25/01/06 DRN.JOBI.PC

SHIPRA'S SHILP
ARCHITECT,PLANNER,INTERIOR DESIGNER
B-37/GFIRST FLOOR,VASHI PLAZA,SEC. 17,VASHI
NAVI MUMBAI 400703 TELEFAX:55912782

AS BUILT DRAWING

Approved subject to the conditions mention in this office letter No. CIDCO/ ATP0/ 1361 dtd. 17/8/07

Additional Town Planning Officer, CIDCO of Maharashtra Ltd. 4th Floor, Raigad Bhavan, Sector 11, C.B.D. Belapur, Navi Mumbai.

TRUE COPY

A. D. SHROFF
Notary Greater Bombay
Shop No. 00, Dr. Ambedkar Road
Opp. B. J. P. Office,
Chembur Colony, Mumbai- 400 074.

NOTE:
ARTIFICIAL LIGHT AND VENTILATION SHALL BE PROVIDED AS PER NBC PART 8 CLAUSES 4.1.2 AND 4.1.2.2 AND ANY MODIFICATIONS THERE OF.

STAMP AND DATE OF APPROVAL

LIGHT & 1/6 VENTILATION STATEMENT

S.N.	F. NO	ROOM	SIZE	AREA	1/6th AREA	VIZION PROV.
(1)	GR.FL	FLORIST	2.55X8.45	16.44	2.74	4.41
		BOOKSHOP	2.46X4.45 +	15.88	2.64	4.41
		CHEMIST	2.55X6.60	16.83	2.80	4.41
		CHEMIST	2.55X9.65	24.61	4.10	4.41
		CAFETERIA	2.46X 3.6	23.76	3.96	8.21
		CAFETERIA	2.55 X9.6	24.48	4.01	
(2)	1st.FL	HOSPITAL	2.55 X9.6	24.48	4.01	8.21
		1(1)	1.5X2.1	2.99	0.498	0.54
		1(2)	1.0X2.1	1.14	0.19	0.72
(3)	2nd.FL	BED	4.115X2.704	11.129	1.854	2.88
		BED	3.115X3.756	11.843	1.974	2.88
		1(3)	1.5X2.1	2.99	0.498	0.54
		TOI	CLEARX2.3	0.75 X 10		

SCHEDULE OF DOORS & WINDOWS

S.N.	TYPE	DESCRIPTION	SIZE	AREA
(1)	D	T.W. DECORATIVE	1.5X2.1	3.15
(2)	D1	T.W. DECORATIVE	1.0X2.10	2.10
(3)	D2	SINTEX DOORS	0.75X2.10	1.575
(4)	W1	AL.SLIDING G.WINDOW	3.00X1.80	5.40
(5)	W2	AL.SLIDING G.WINDOW	2.4X1.8	4.32
(6)	W3	AL.SLIDING G.WINDOW	4.0X1.8	7.20
(7)	W4	AL.SLIDING G.WINDOW	1.2X1.2	1.44

WATER STORAGE CAL.

		UNIT	MEM.	/LT	TOTAL
HEALTH USER	10 BED HOSP. ON EACH FLOOR	6	10	340LTR	20,400
COMM	10 BED HOSP.	6	3	45LTR	810
RES	UNIT OF BUA 60 SQ.M.	1	7	200LTR	1400
TOTAL					22,610
U.G TANK REQUIREMENT 50% OF TOTAL QUANTITY					11,305
	PROPOSED				30,000
O.H TANK REQUIREMENT 75% OF TOTAL QUANTITY					16,960
	PROPOSED				20,000

PARKING DETAILS

	REQ.NO	UNIT	PROP.NO
SHOPPING	1 NO. FOR 80 SQ.M.	86.54	1
HEALTH USER	1 NO. 150 SQ.M.	785.34	5
RES.	1 NO FOR 2UNITS OF B.U.A MORE THAN 45SQ.M. UPTO 60 SQM	1	1
VISITORS	10% OF TOTAL PARKING SPACES		1
	TOTAL		8

NAME AND SIGN OF OWNER

Vijaykumar Omprakash Agarwal
Shrimati Vijaykumar Agarwal

NAME AND SIGN OF ARCHITECT

PROP. HOSPITAL ON PLOT NO 5A
SEC.4, KHARGHAR, NAVI MUMBAI